

00 91 00 – ADDENDUM NO. 2

Issued to All Bid Document Holders of Record

Date: October 18, 2018
Project Name: Chlorination System Improvements Water Treatment Plant
Project No.: VRNTL-18-8-08
BMCD Project No.: 104587

This Addendum forms a part of the Contract described above. The original Contract Documents and any prior Addenda remain in full force and effect except as modified by the following which shall take precedence over any contrary provisions in the prior documents.

QUESTIONS FROM PRE-BID MEETING:

1. *Who is responsible for the first supply of chemical?*

Response: The Village will be responsible for the first supply of chemical.

2. *Is the electrical panel to be removed and replaced?*

Response: Yes, Specification Section 26 00 00 calls for the disconnection and removal of the existing 120/208vac, 12 circuit, panelboard “Panel CL” and the furnish and installment of a new 120/208vac, 100A main, 24 circuit panelboard.

- a. *Is the fan to stay in place or be removed?*

Response: The fan is to be removed.

- b. *What is the required amperage of the panel and is there enough power currently available?*

Response: The new panel shall be a 120/208vac, 100A main, 24 circuit panelboard. The electrical feed is on a 60A breaker but is sufficient to power the proposed improvements.

3. *Is PVC an acceptable material for the electrical conduit?*

Response: Yes, PVC is acceptable.

4. *Are ultrasonic level sensors acceptable for the tanks?*

Response: Yes, ultrasonic level sensors are acceptable.

5. *Should corp stops be installed at the East and West Water Treatment Plants?*

Response: Yes, corp stops should be installed.

6. *Should the transfer pump include a dead man switch?*

Response: Yes, the transfer pump should include a control switch.

7. *How much piping is required to connect to the East and West Treatment plants?*

Response: Connection to the West WTP will require approximately 160 feet of CPVC piping. Connection to the East WTP will require approximately 240 feet of CPVC piping. Please refer to the attached record drawing for general routing.

00 91 00 – ADDENDUM NO. 2: continued

Each Bidder shall acknowledge receipt of this Addendum by affixing his signature below, by noting this Addendum on his Bid Form, and by attaching this Addendum to his Bid.

Burns & McDonnell Engineering Company
1431 Opus Place, Suite 400
Downers Grove, Illinois 60515

ACKNOWLEDGEMENT


The undersigned acknowledges receipt of this Addendum and the Bid submitted is in accordance with information, instructions and stipulations set forth herein.

Bidder: _____


By: _____

Date: _____

END OF 00 91 00

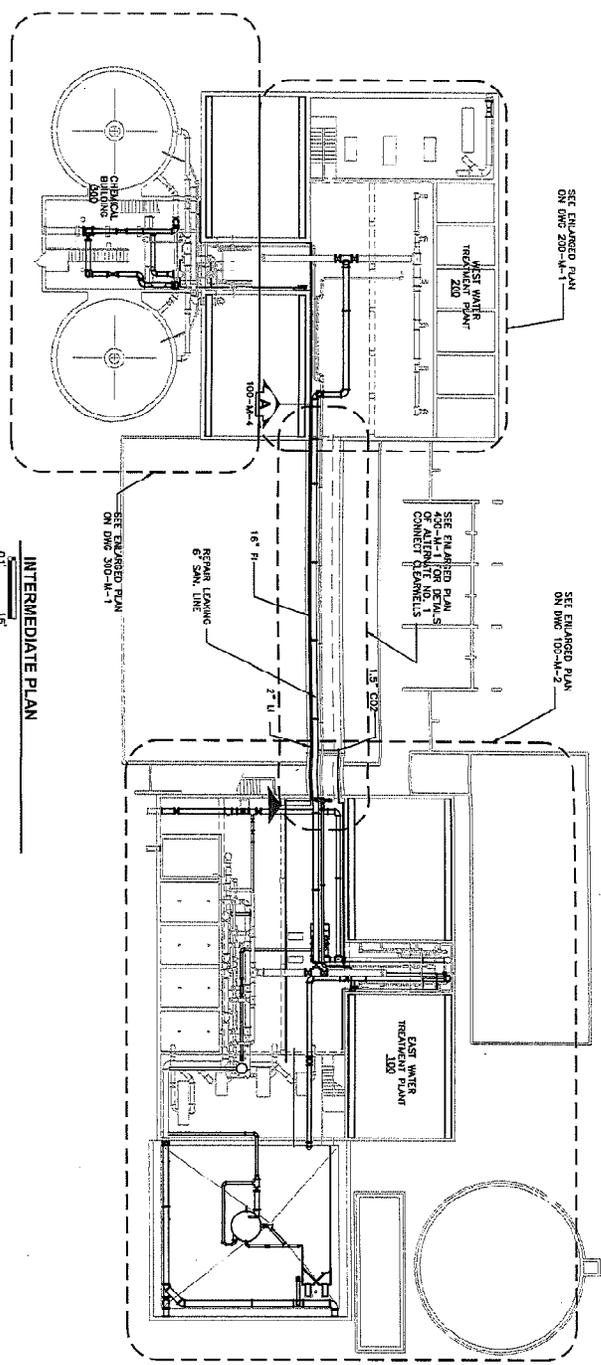

INTERMEDIATE PLAN
0" = 16'

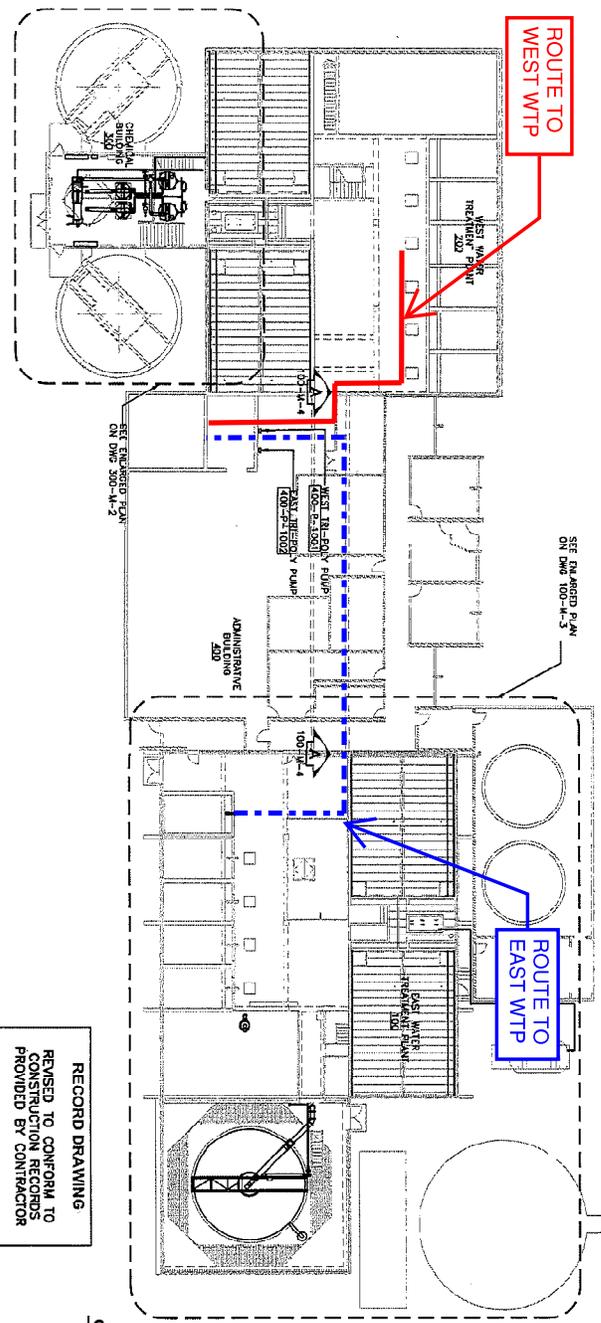

GRADE PLAN
0" = 16'

RECORD DRAWING
REVISED TO CONFORM TO
CONSTRUCTION RECORDS
PROVIDED BY CONTRACTOR
BR-92E PERUA DATE: 10/22/09

- GENERAL NOTES:**
1. ALL U SPRING TO HAVE SURVEY ADDED. LOCATIONS IN ANY LOCATION WHERE DIRECTION CHANGES. SEE TYPICAL DETAIL, 100-M-5.
 2. LOCATION OF U SPRING IS APPROXIMATE. CONSTRUCTION BEYOND.
 3. U SPRING TO BE INSTALLED WITH NO TYPERS IN ANY LOCATION.

| DORR CONSTRUCTION SHEET NO. 45 DRAWING NO. 100-M-1 | VILLAGE OF RANTOUL EAST WATER TREATMENT PLANT RECONSTRUCTION RANTOUL, ILLINOIS EAST WATER TREATMENT PLANT PLAN | <table border="1" style="width: 100%; border-collapse: collapse;"> <thead> <tr> <th>Revision Number</th> <th>Revision Description</th> <th>Drawn By</th> <th>Checked By</th> <th>Date</th> </tr> </thead> <tbody> <tr> <td> </td> <td> </td> <td> </td> <td> </td> <td> </td> </tr> </tbody> </table> | Revision Number | Revision Description | Drawn By | Checked By | Date | | | | | | <table border="1" style="width: 100%; border-collapse: collapse;"> <tr> <td>Designed By</td> <td>NAB</td> </tr> <tr> <td>Drawn By</td> <td>NAB</td> </tr> <tr> <td>Checked By</td> <td>JAP</td> </tr> <tr> <td>Approved By</td> <td>JAP</td> </tr> <tr> <td>Filename</td> <td>100M-1DWG</td> </tr> <tr> <td>Project No.</td> <td>11129</td> </tr> <tr> <td>Project Date</td> <td>03/01/2007</td> </tr> </table> | Designed By | NAB | Drawn By | NAB | Checked By | JAP | Approved By | JAP | Filename | 100M-1DWG | Project No. | 11129 | Project Date | 03/01/2007 |
|---|--|---|-----------------|----------------------|----------|------------|------|--|--|--|--|--|---|-------------|-----|----------|-----|------------|-----|-------------|-----|----------|-----------|-------------|-------|--------------|------------|
| Revision Number | Revision Description | Drawn By | Checked By | Date | | | | | | | | | | | | | | | | | | | | | | | |
| | | | | | | | | | | | | | | | | | | | | | | | | | | | |
| Designed By | NAB | | | | | | | | | | | | | | | | | | | | | | | | | | |
| Drawn By | NAB | | | | | | | | | | | | | | | | | | | | | | | | | | |
| Checked By | JAP | | | | | | | | | | | | | | | | | | | | | | | | | | |
| Approved By | JAP | | | | | | | | | | | | | | | | | | | | | | | | | | |
| Filename | 100M-1DWG | | | | | | | | | | | | | | | | | | | | | | | | | | |
| Project No. | 11129 | | | | | | | | | | | | | | | | | | | | | | | | | | |
| Project Date | 03/01/2007 | | | | | | | | | | | | | | | | | | | | | | | | | | |

